
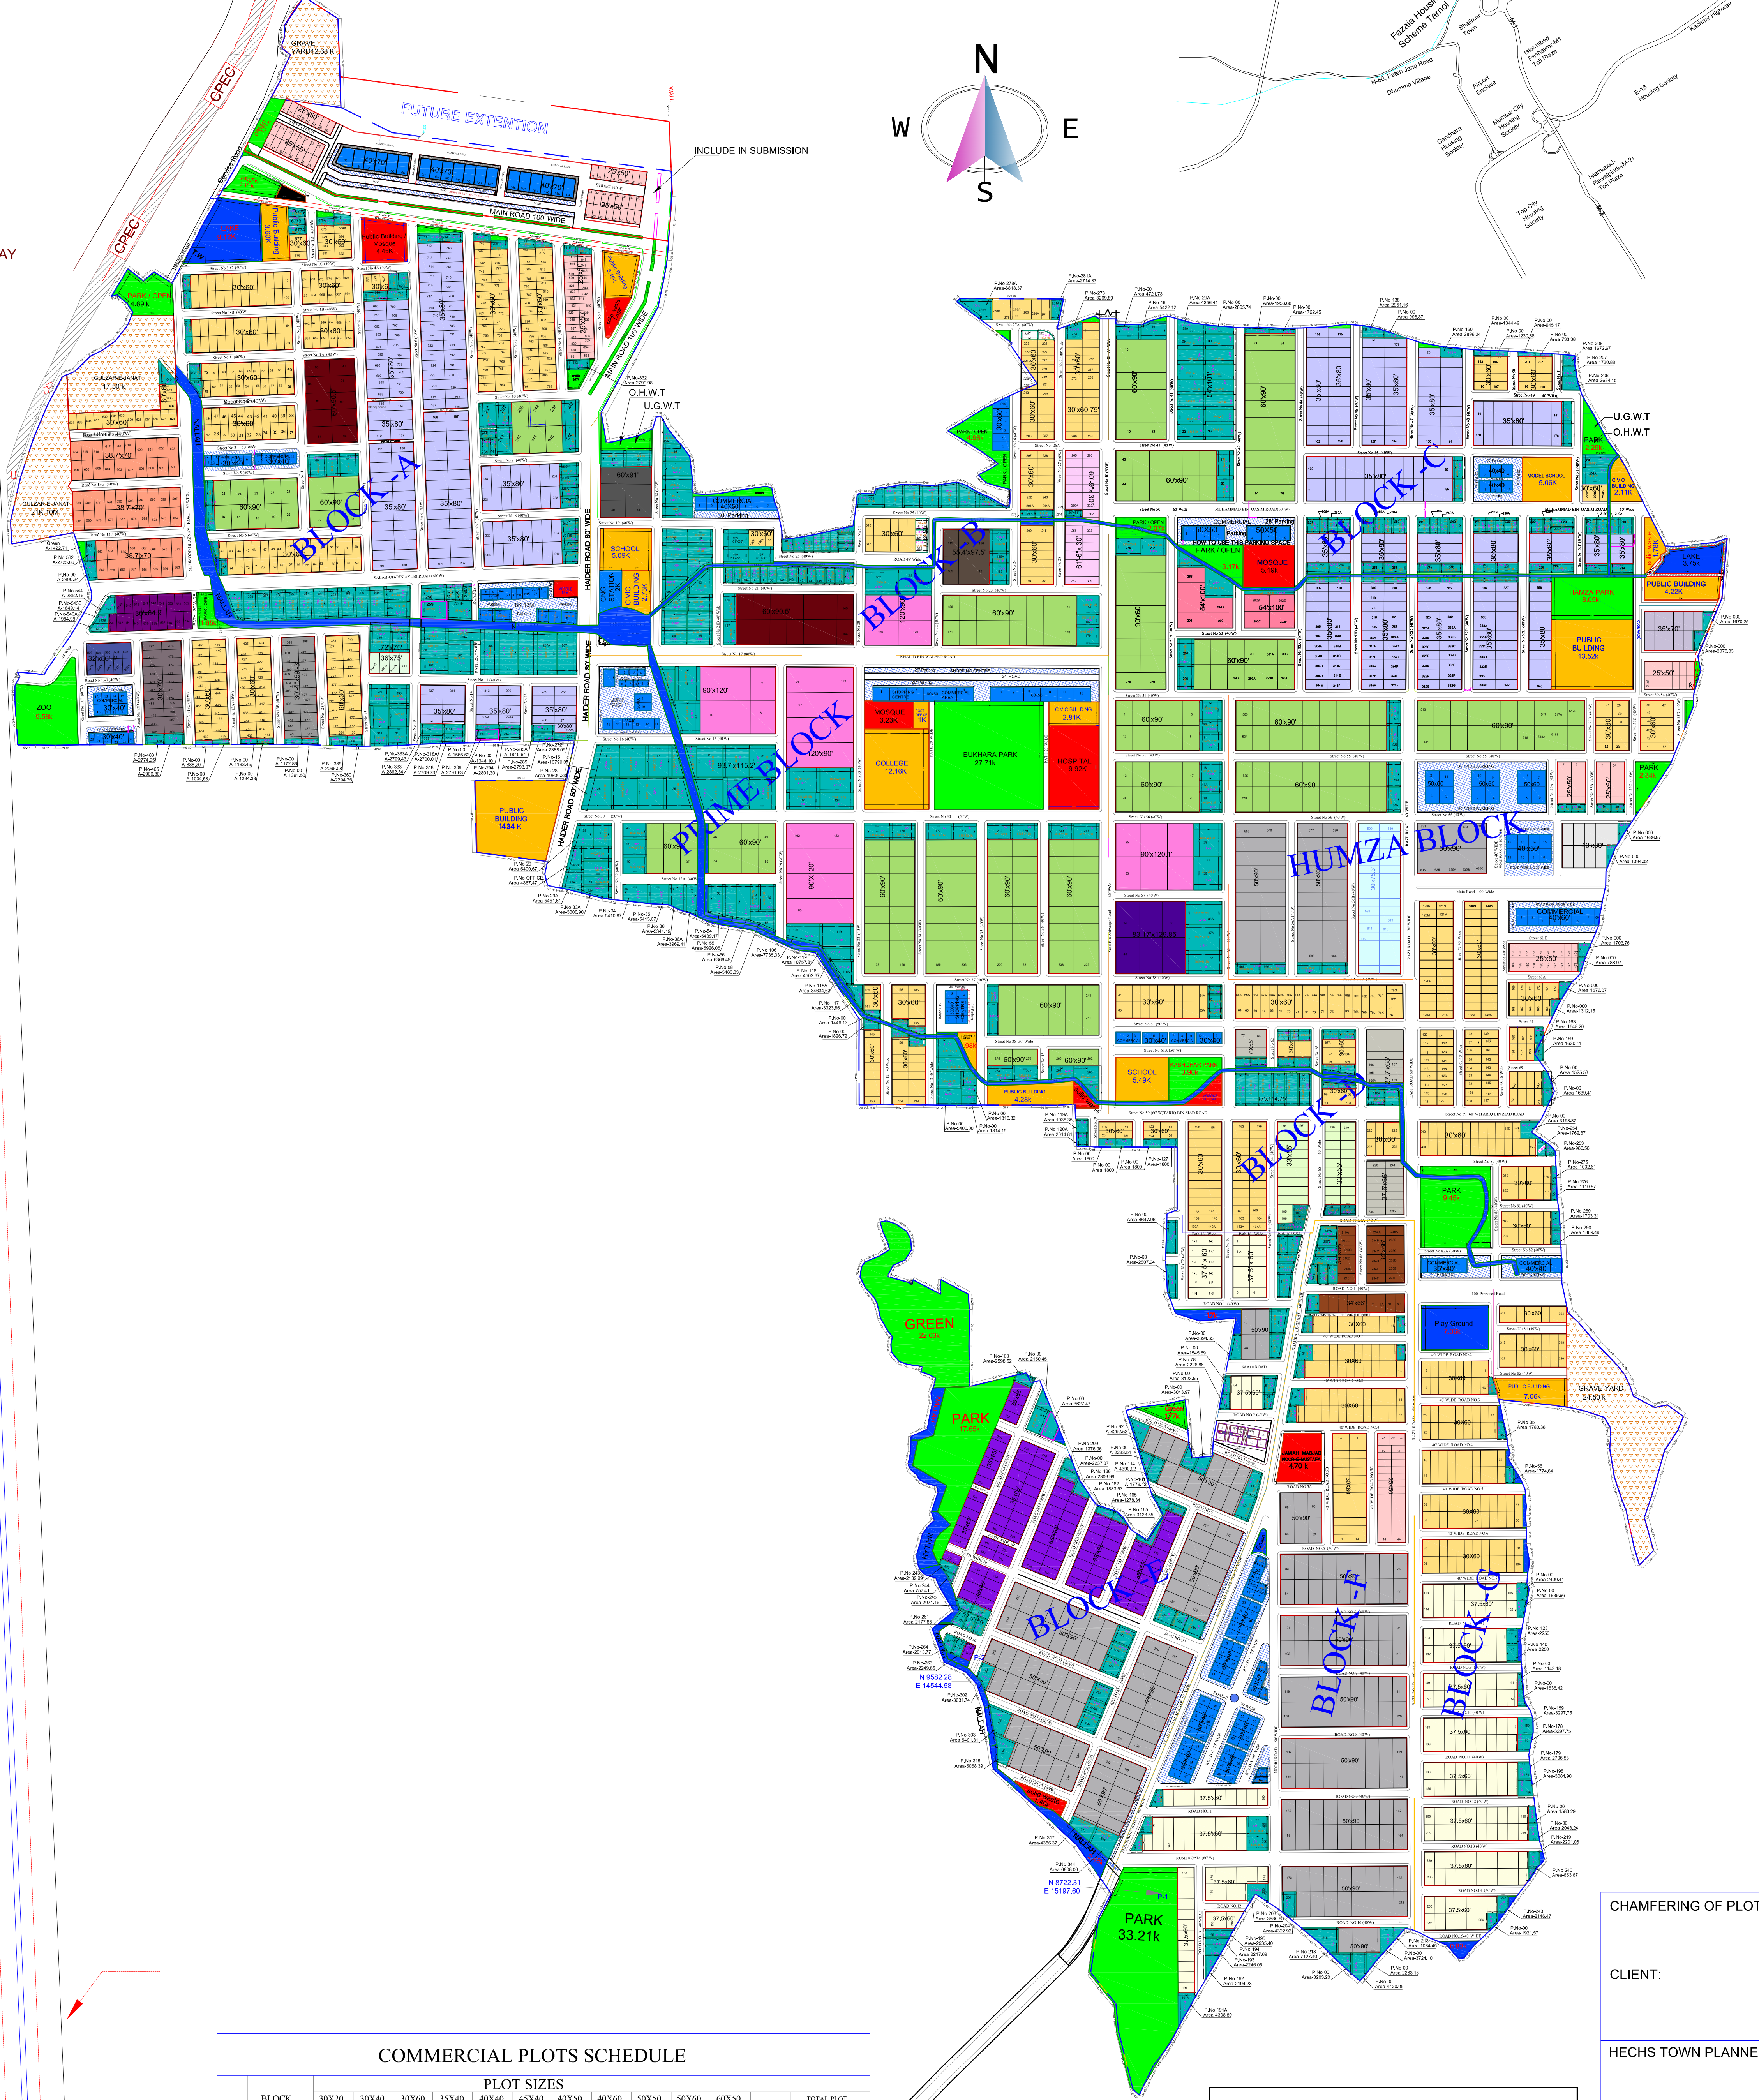
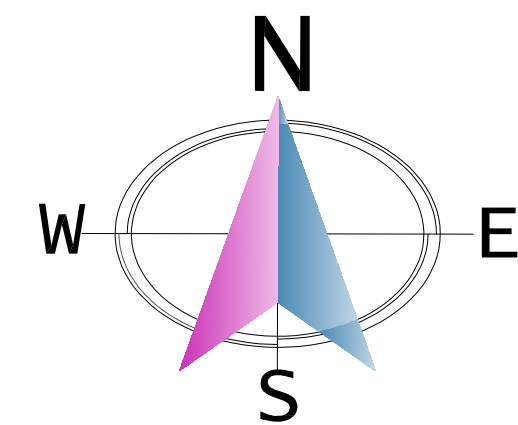


ENDORSEMENT OF AS BUILT LAYOUT PLAN
HEALTH EMPLOYEES COOPERATIVE HOUSING SOCIETY
(GULSHEN-E-SEHAT-E-18)

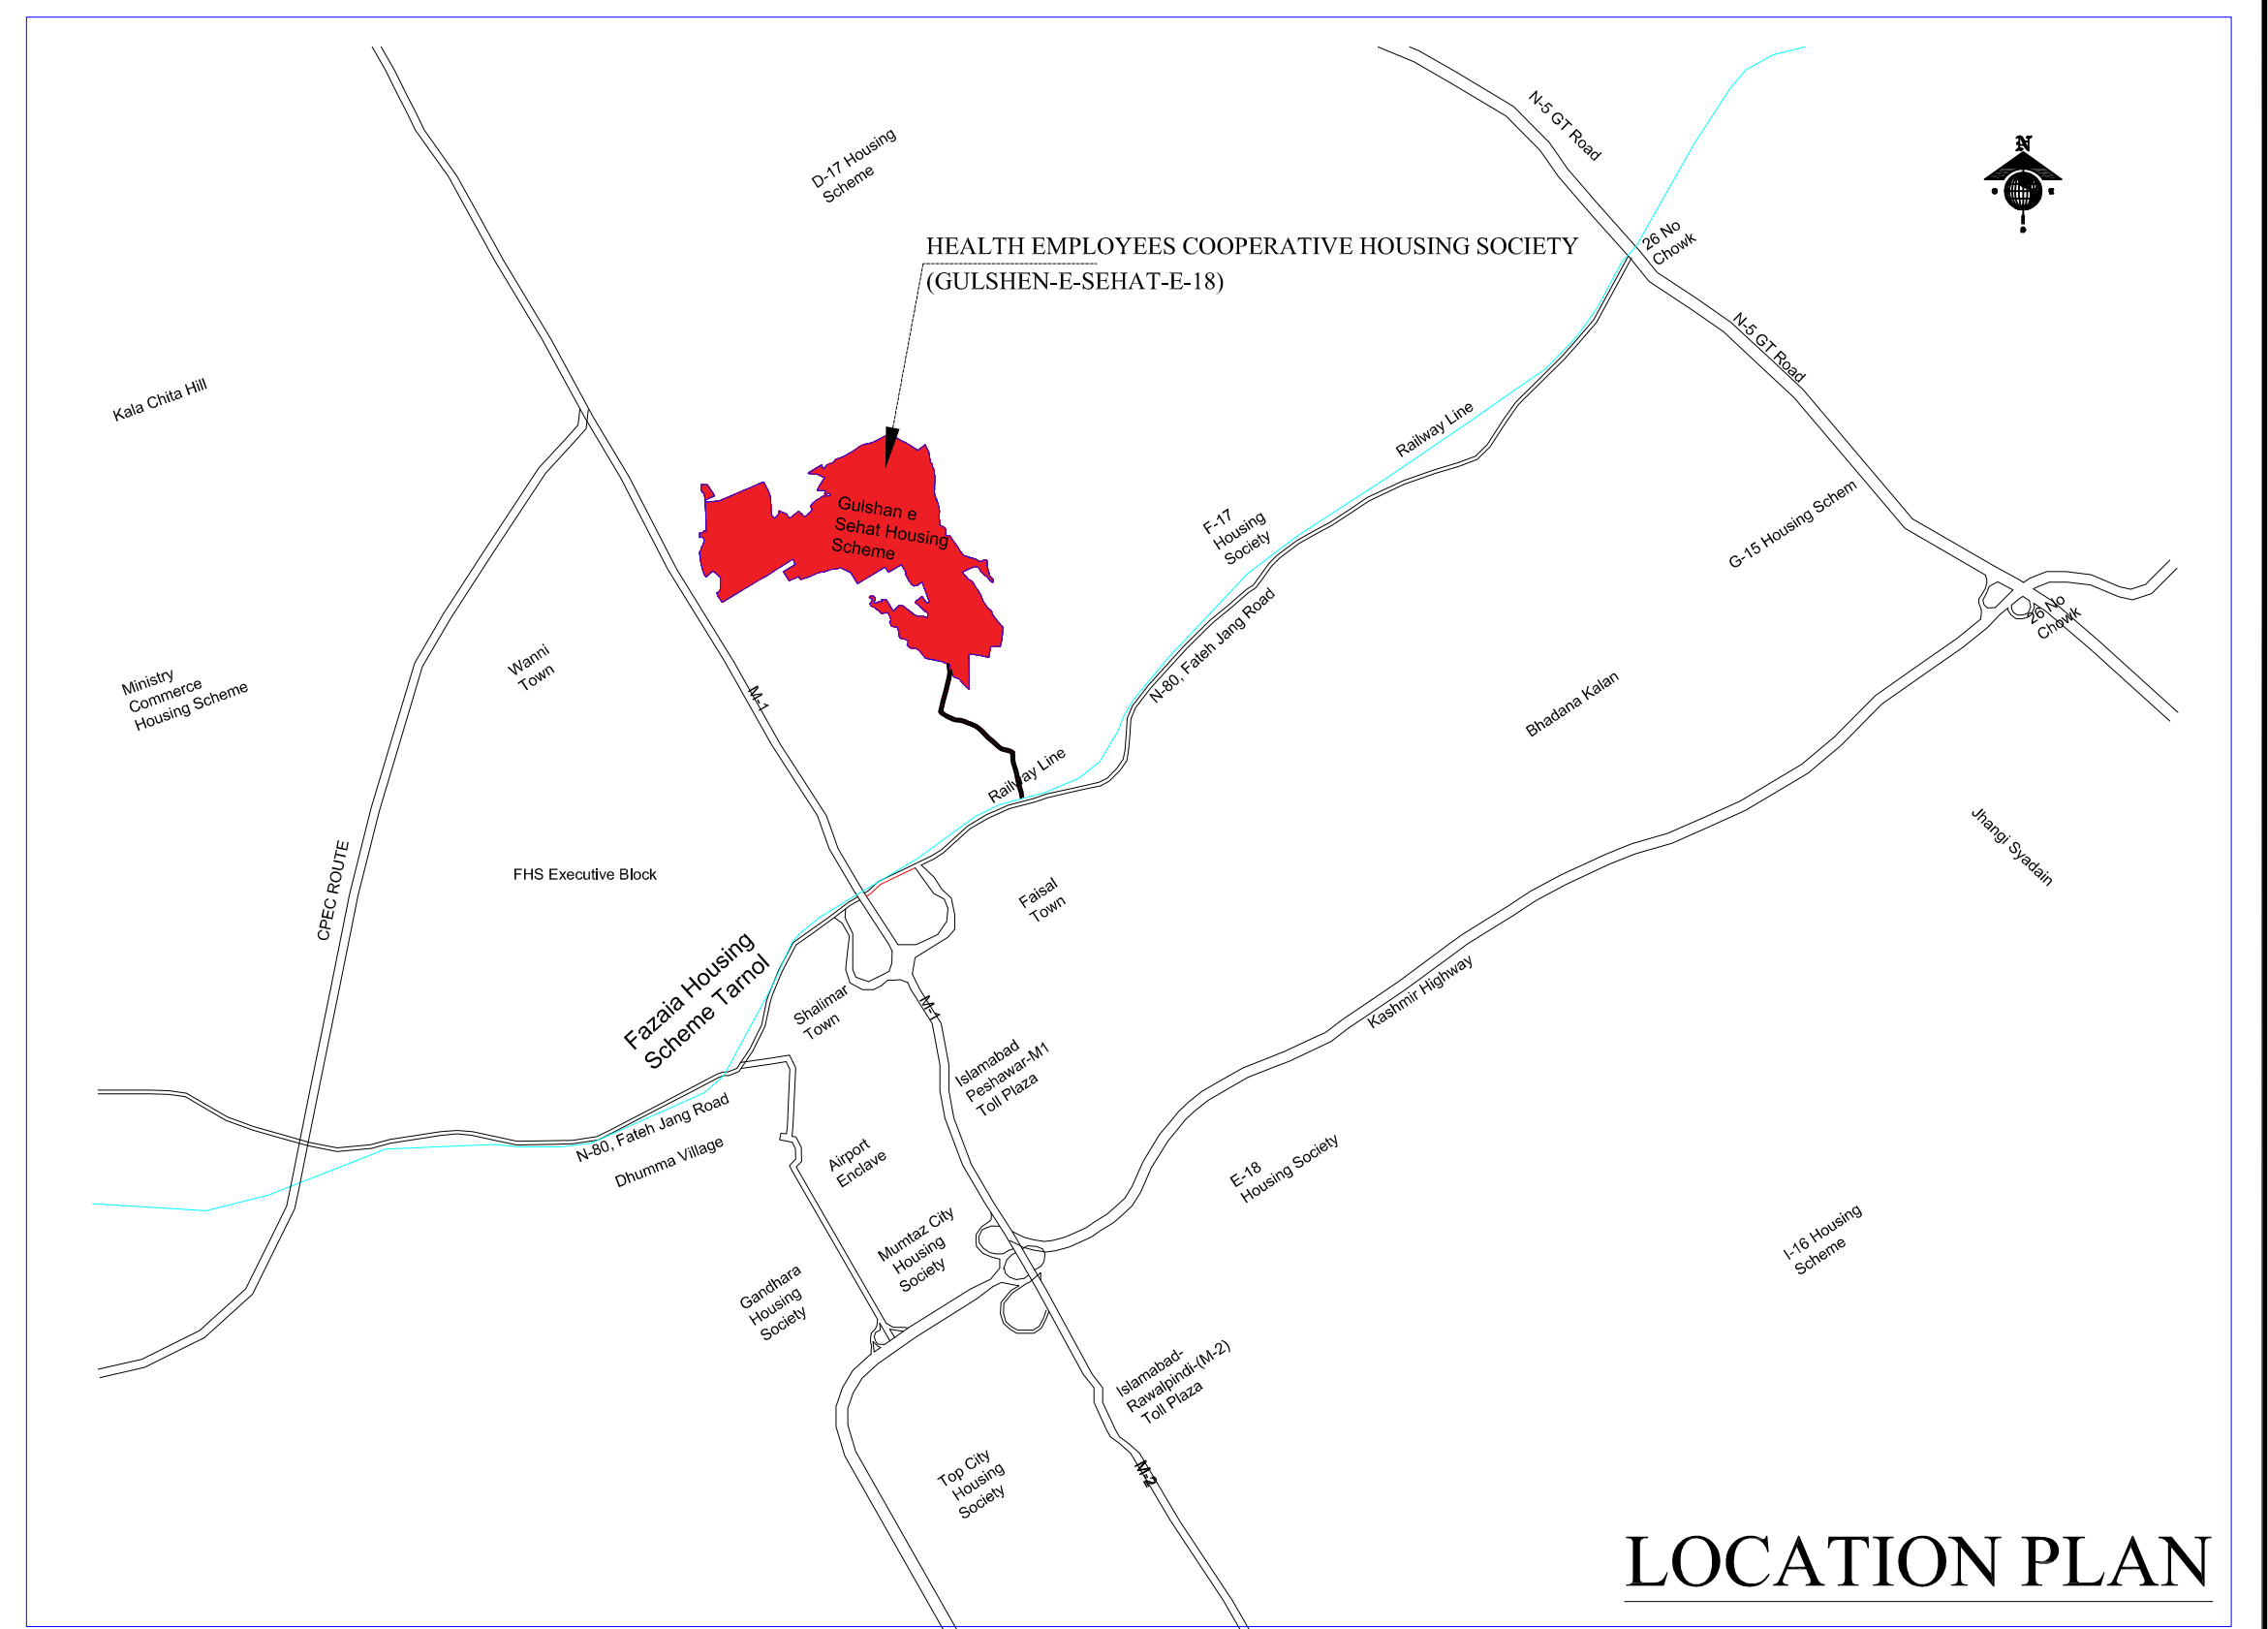

BLOCK BOUNDARY LEGEND	
BLOCK -A	
BLOCK -B	
BLOCK -C	
BLOCK -D	
BLOCK -E	
BLOCK -F	
BLOCK -G	
HUMZA BLOCK	
UNIQUE BLOCK	
PRIME BLOCK	

COMMERCIAL PLOTS SCHEDULE														
SR.NO	BLOCK NAMES	PLOT SIZES												TOTAL PLOT NUMBER BLOCK WISE
		30X20	30X40	30X60	35X40	40X40	45X40	40X50	40X60	50X50	50X60	60X50	ODD	
01	A	06	28	00	00	00	00	00	00	00	00	00	11	45
02	B	00	00	05	00	00	00	06	00	00	00	00	03	14
03	C	00	00	00	00	06	00	00	00	06	00	00	00	12
04	D	00	12	00	04	04	00	00	00	00	00	00	01	21
05	E	00	10	00	00	00	00	00	00	00	00	00	00	10
06	F	00	58	00	00	00	00	00	00	00	00	00	06	64
07	G	00	00	00	00	00	00	00	00	00	00	00	00	00
08	UNIQUE	00	00	00	00	00	22	00	00	00	00	00	00	22
09	PRIME	00	08	02	05	00	00	00	00	00	00	00	12	09
10	HAMZA	00	00	00	00	00	08	07	00	12	00	00	01	28
TOTAL PLOTS		06	116	07	09	10	22	14	07	06	12	12	31	252

LAND-USE DISTRIBUTION (TOTAL BOUNDARY)			
DESCRIPTION	AREA IN SFT	AREA IN KANAL	%AREA
RESIDENTIAL	9974926.103	1831.942	53.7
COMMERCIAL	472416.440	86.762	2.5
PUBLIC AMENITIES	987357.808	181.333	5.3
PARKS / GREEN / NULLAH	1634768.924	300.233	8.8
ROADS / PARKIN	5139164.604	943.832	27.6
GRAVE YARD	382085.641	70.172	2.1
TOTAL	18590719.520	3414.274	100.0

SCHEDULE OF RESIDENTIAL PLOTS																																	
SR.NO	BLOCK NAMES	PLOT SIZES																												TOTAL PLOT BLOCK WISE			
		25X50	27.5X66	30.4X59.3	30X60	30X64.9	30X70	30X75.3	30X80	32.7X55	32X56.4	33X55	34X66	35X65	35X70	35X80	36X75	37.5X60	38.7X70	40X80	50X100	50X90	54X100	55.4X97.5	60X90.5	60X91	61.6X70	83.1X120.8	90X120.1		ODD		
01	A	30	00	00	24	319	19	22	00	1	00	10	00	00	00	00	176	4	00	56	00	00	00	00	00	22	00	00	00	00	113	796	
02	B	00	00	00	98	00	00	00	00	00	00	00	00	00	00	6	00	00	00	00	00	00	00	6	16	14	6	29	00	4	74	253	
03	C	00	00	00	19	00	00	00	00	00	00	00	00	00	00	263	00	00	00	00	00	00	10	00	72	00	00	00	00	00	89	453	
04	D	00	28	00	218	00	00	00	00	6	00	38	00	00	00	00	00	00	00	00	00	00	00	00	20	00	00	00	6	6	52	374	
05	E	00	00	00	00	00	00	00	00	00	00	00	00	00	00	102	00	00	30	00	00	98	00	00	00	00	00	00	00	00	56	286	
06	F	31	00	00	83	00	00	00	00	00	00	00	00	00	00	27	00	00	00	54	00	00	117	00	00	00	00	00	00	00	00	33	345
07	G	00	00	00	102	00	00	00	00	00	00	00	00	00	00	00	00	141	00	00	00	00	00	00	00	00	00	00	00	00	19	262	
08	UNIQUE	00	00	00	00	00	00	00	00	00	00	00	00	00	00	00	00	00	00	00	00	00	00	00	00	00	00	00	00	00	00	00	
09	PRIME	00	00	00	36	00	00	00	00	00	00	00	00	00	00	00	00	00	00	00	00	00	00	00	95	00	00	00	00	22	77	230	
10	HAMZA	58	00	00	141	00	00	36	00	00	00	00	00	00	00	11	00	00	00	9	00	50	00	00	56	00	00	00	00	00	23	384	
TOTAL PLOTS		119	28	24	1016	19	22	36	1	6	10	38	27	102	17	439	4	225	56	9	00	265	10	6	281	14	6	29	6	32	536	3383	

CHAMFERING OF PLOTS 10'-0"

CLIENT:

HECHS TOWN PLANNER:

MUHAMMAD KHALID

SOCIETY PRESIDENT

ASSITT. DIRECTOR PLANNING:

DY.DIRECTOR PLANNING

DIRECTOR MP.&E

DIRECTOR GENERAL

Designmen CONSULTING ENGINEERS (PVT.) LTD.

1st Floor, Block B West, Nazim Plaza, Jinnah Avenue F-6, (ISLAMABAD - PAKISTAN) Ph: 92-51-282577, 2820002 Fax: 92-51-2307615 E-mail: designmenislamabad@gmail.com www.designmen.com

PROJECT: HEALTH EMPLOYEES COOPERATIVE HOUSING SOCIETY (GULSHEN-E-SEHAT-E-18)

TITLE: MASTER LAYOUT PLAN

DRAWN BY: GHULAM MURTAZA CAD CHECK: MAZHAR BHARWAD SCALE: DATE: 10/10/2024 DWG NO: PLAN-01